

DRAWN BY: MPN
 CHECKED: LMN
 L.S. NO. 4233
 EXPIRES: 6-30-2008


REVISED	DATE	DESCRIPTION	BY	APPD

PREPARED FOR:
 NORDIC INDUSTRIES, INC.
 1437 FURNEAUX ROAD MARTISVILLE, CA 95901
 (530) 742-7124

PREPARED BY:
 NORDAHL LAND SURVEYING
 6625 STABULUS RD. VALLEY SPRINGS, CA 95252
 (209) 772-2931

THREE RIVERS LEVEE IMPROVEMENT AUTHORITY
OLIVEHURST DETENTION BASIN
ASBUILT TOPOGRAPHIC SURVEY

PROJECT No. 0547
 SCALE: 1" = 80'
 SHEET 1
 DATE 03/15/07
 OF 1

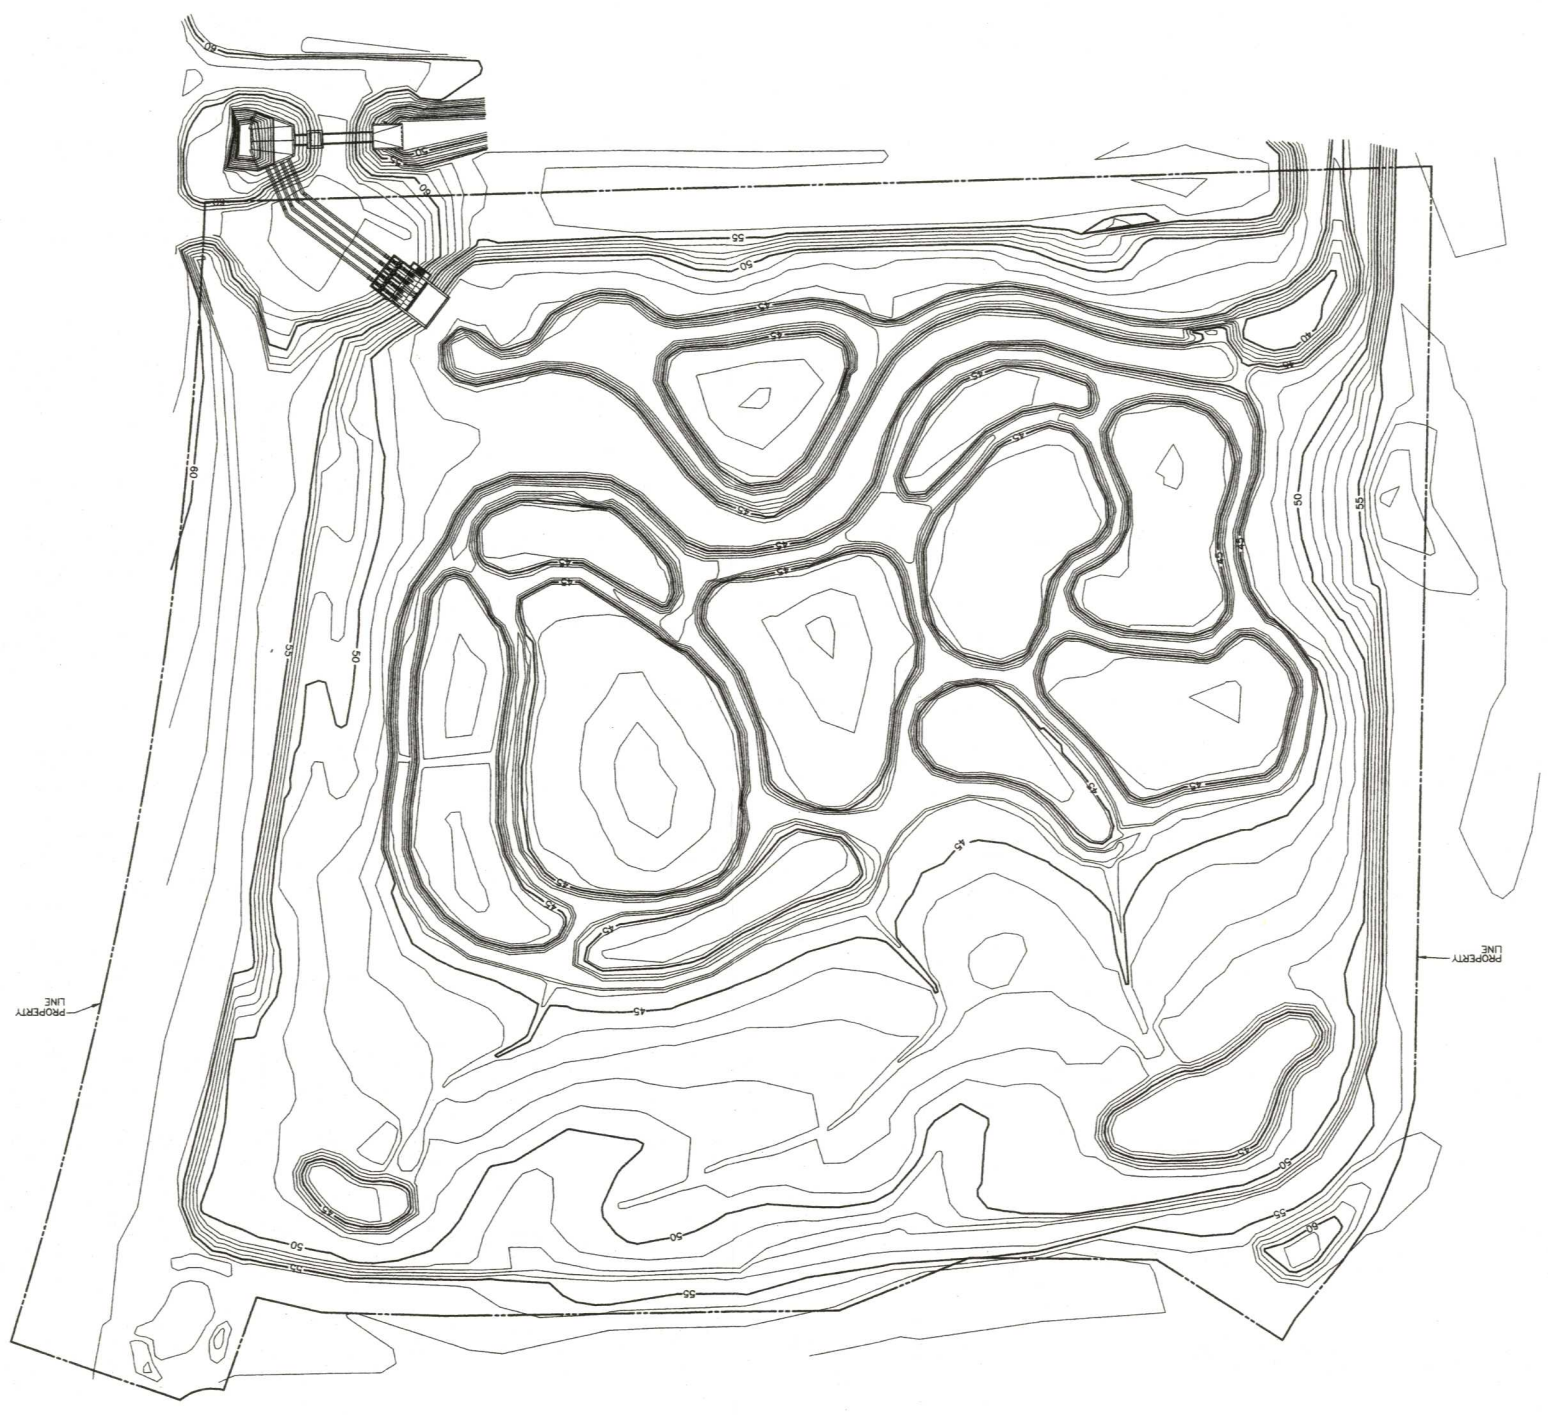

SCALE: 1" = 80'

