

DRAWN BY: MPN  
 CHECKED: LMN  
 L.S. NO. 4233  
 EXPIRES: 6-30-2008


REVISED	DATE	DESCRIPTION	BY	APPD

PREPARED FOR:  
 NORDIC INDUSTRIES, INC.  
 1437 FURNEAUX ROAD MARTISVILLE, CA 95901  
 (530) 742-7124

PREPARED BY:  
 NORDAHL LAND SURVEYING  
 6625 STABULUS RD. VALLEY SPRINGS, CA 95252  
 (209) 772-2931

THREE RIVERS LEVEE IMPROVEMENT AUTHORITY  
 OLIVEHURST DETENTION BASIN  
 ASBUILT TOPOGRAPHIC SURVEY

PROJECT No. 0547  
 SCALE: 1" = 80'  
 SHEET 1  
 DATE 03/15/07  
 OF 1

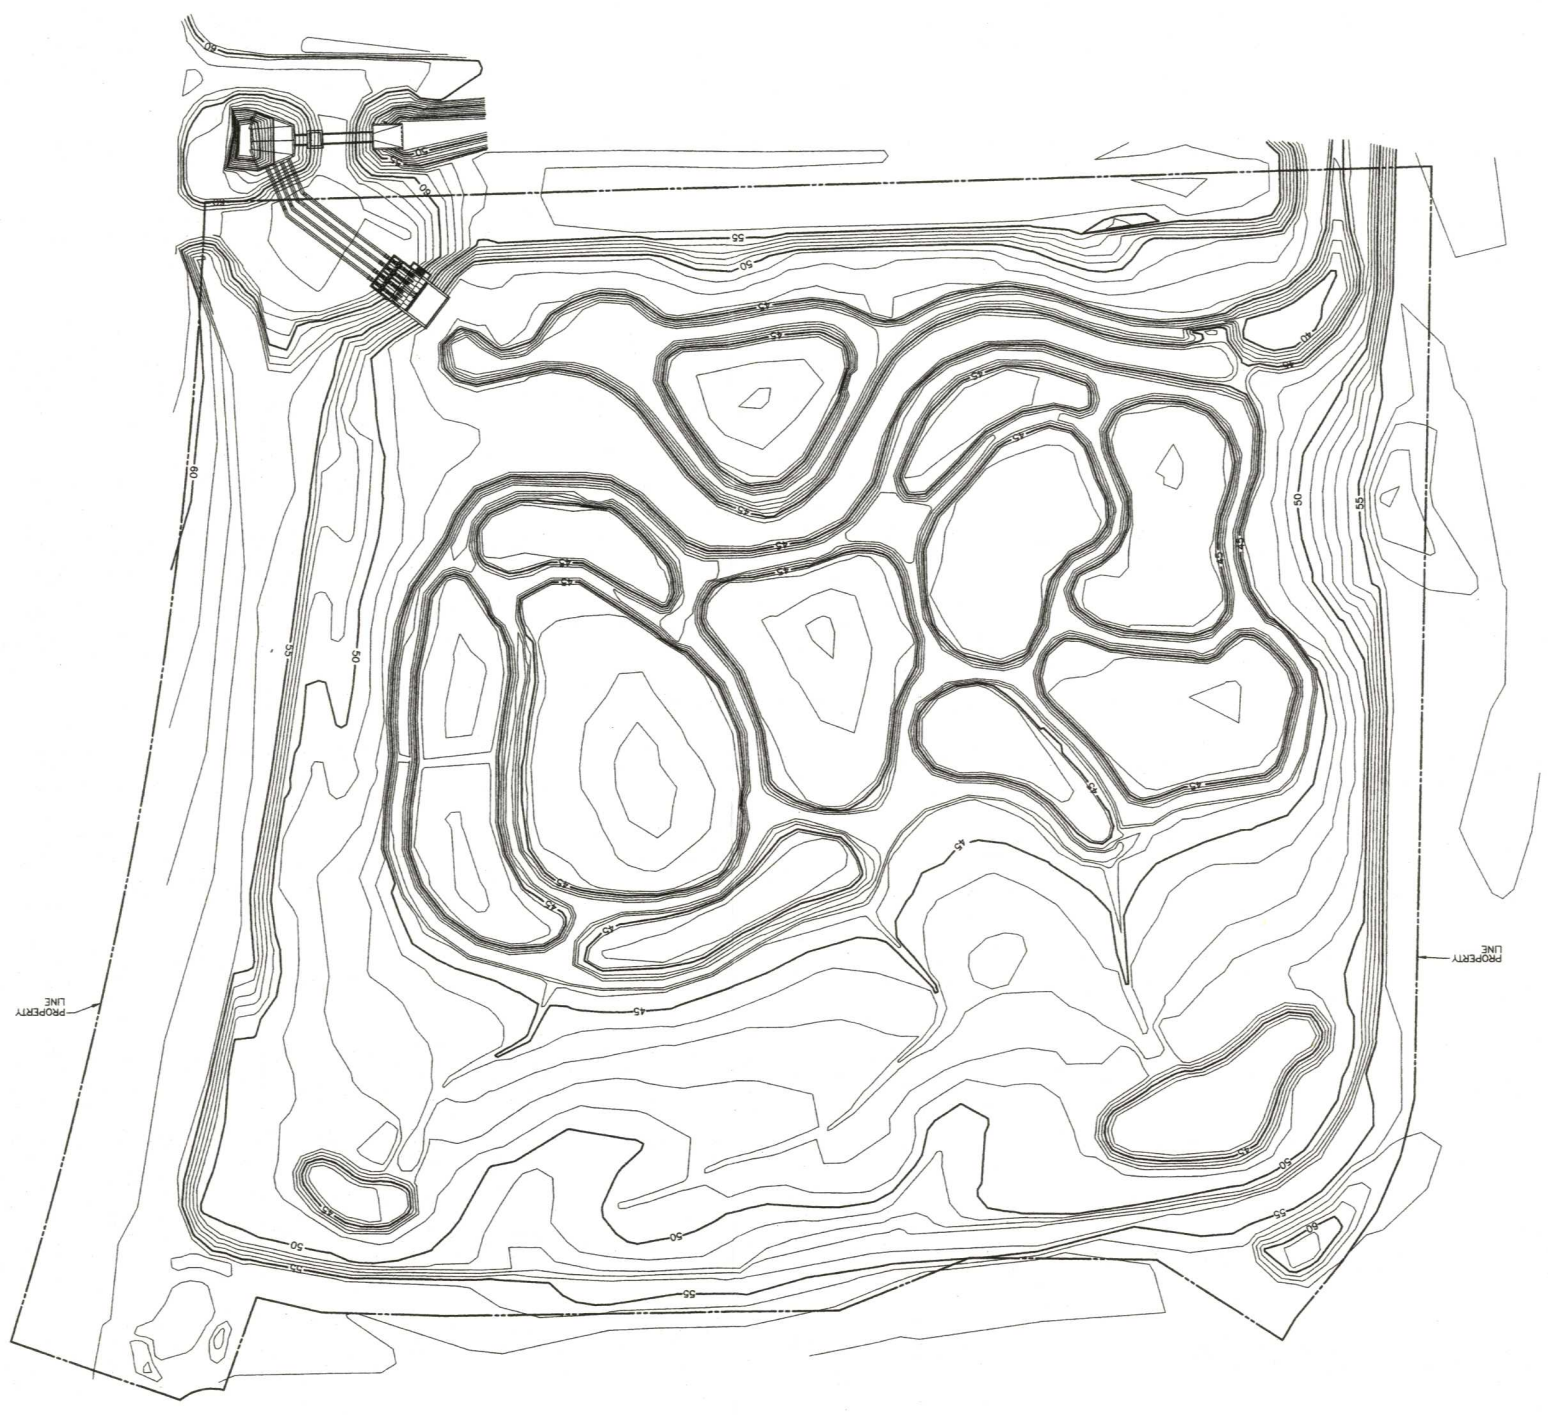

SCALE: 1" = 80'



