


WPIC SLURRY WALL PROFILE

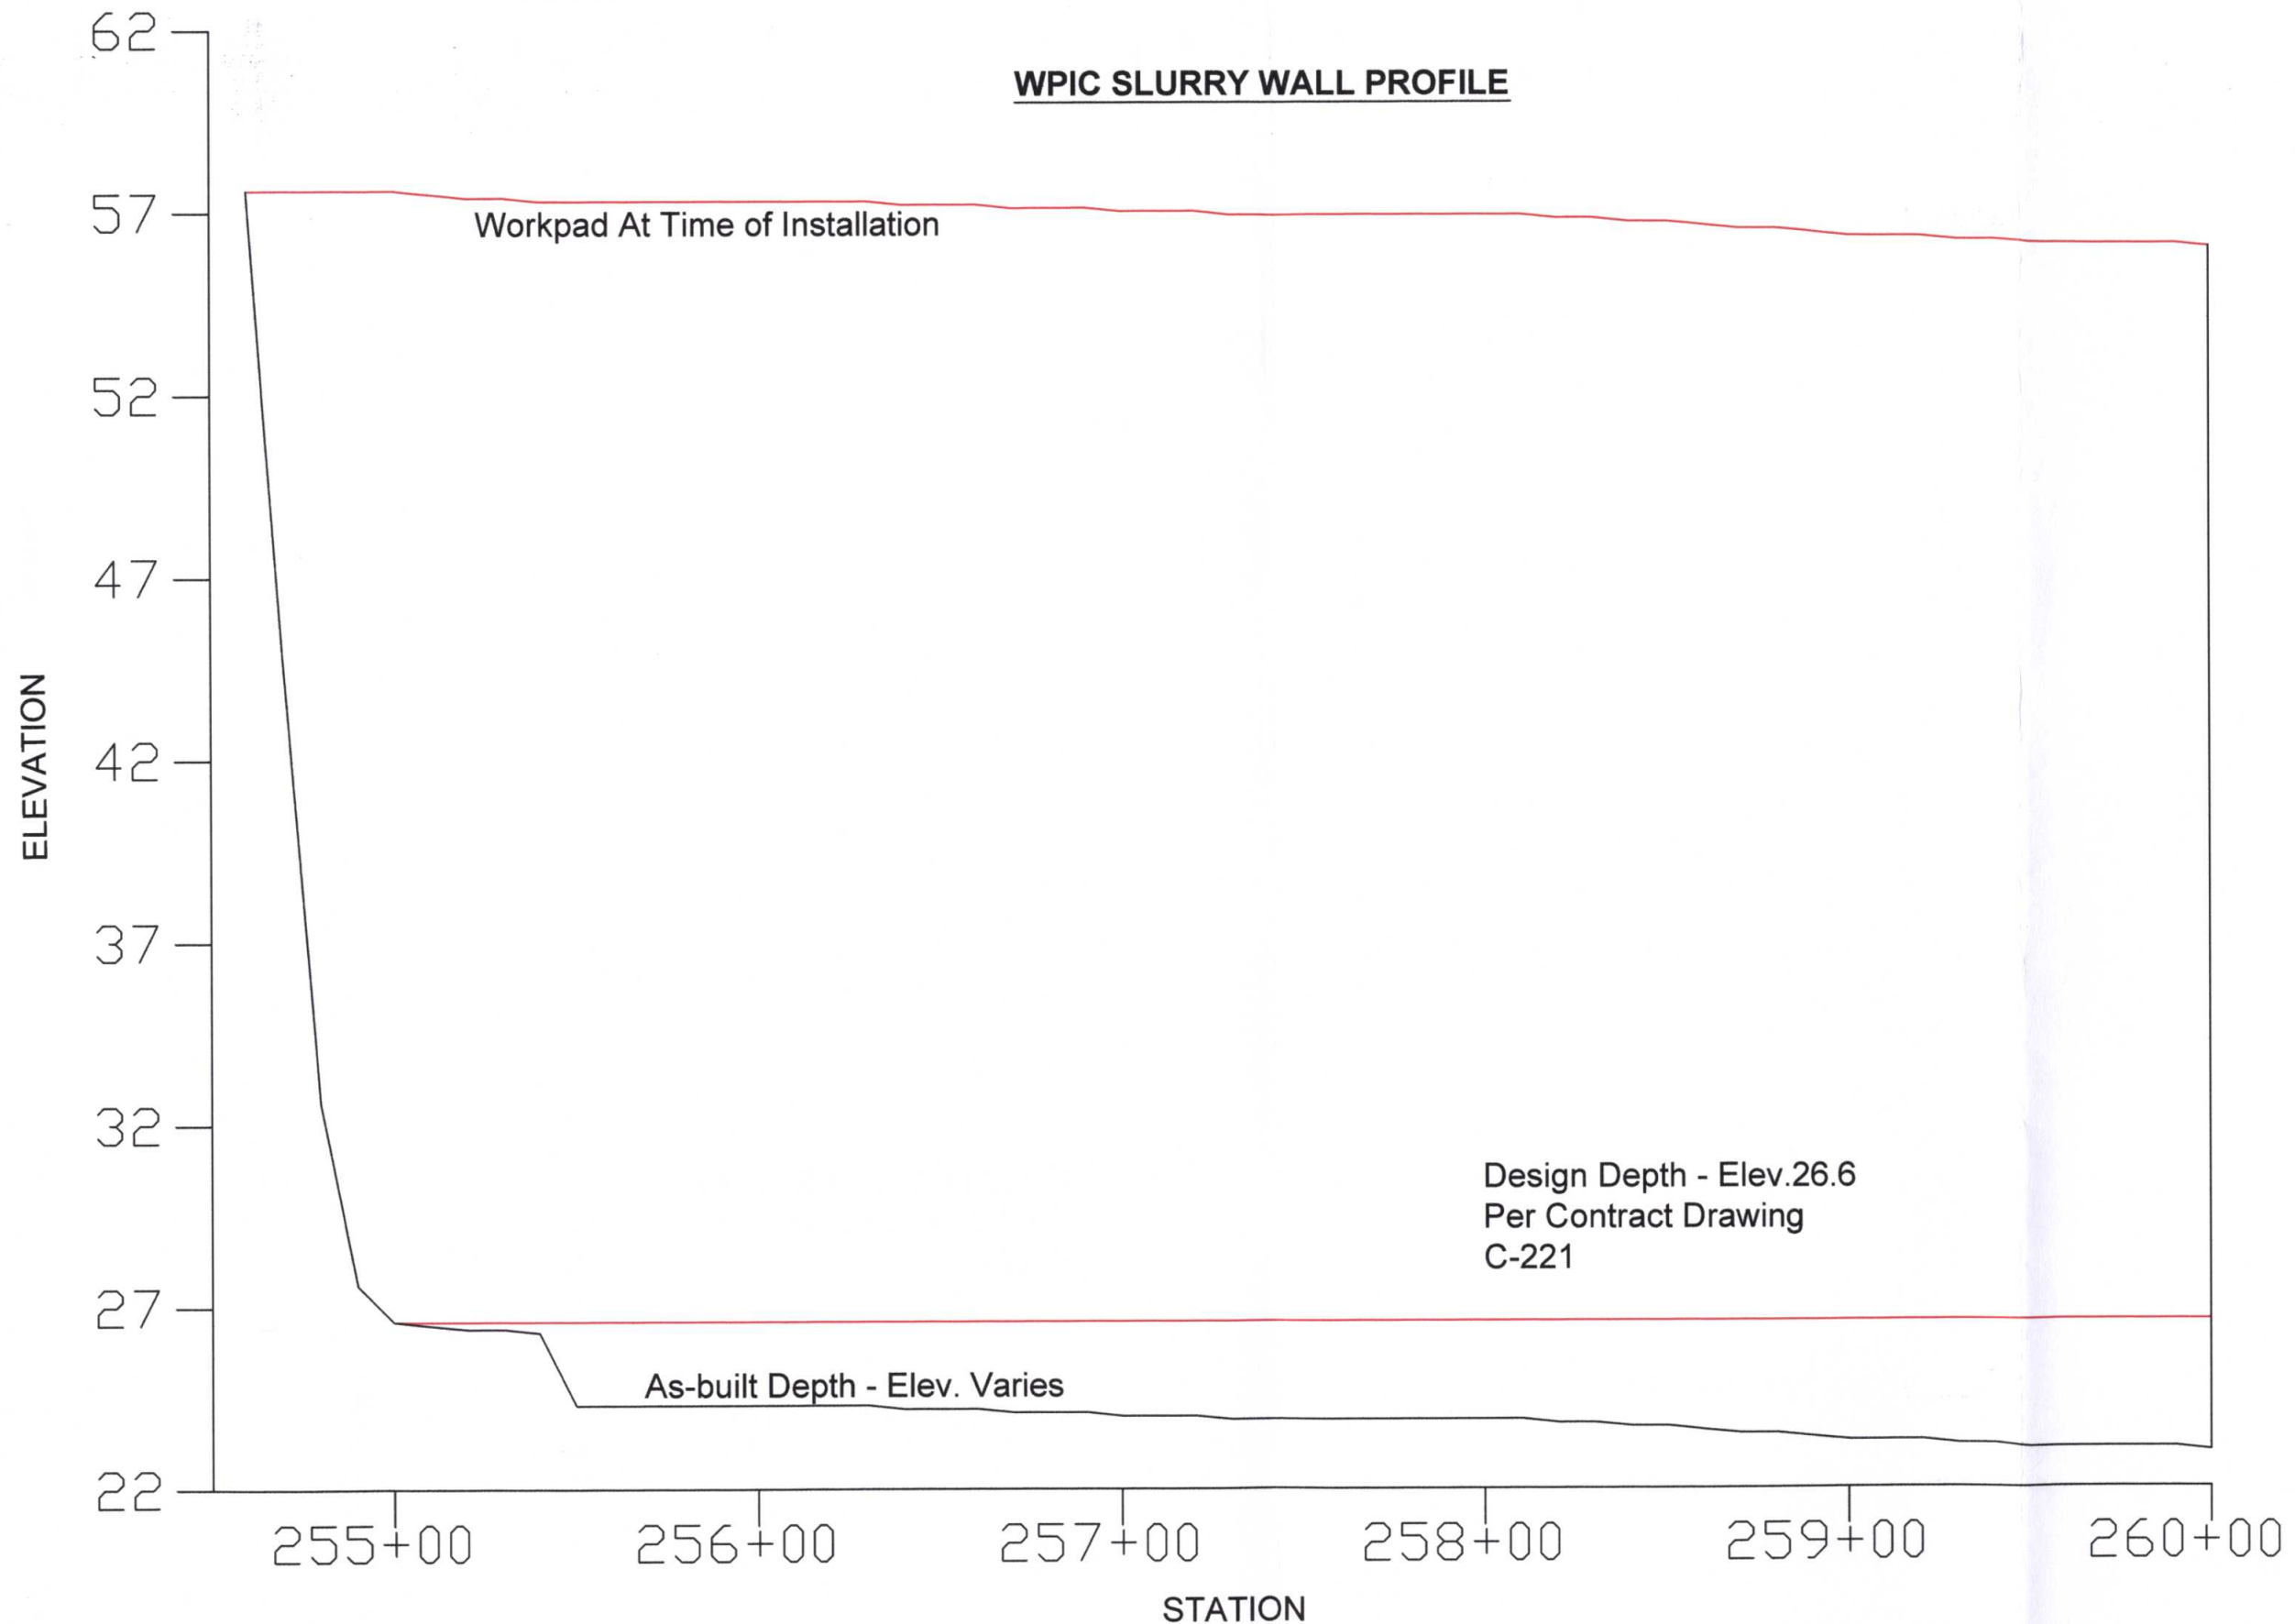

Workpad At Time of Installation

As-built Depth - Elev. Varies

Design Depth - Elev.26.6
Per Contract Drawing
C-221


SLURRY WALL PROFILE, BEAR
RIVER WPIC 255+00 - 260+00



11 Oct 05
SLR
Contract No.
Ph 2-2005/06-01

FIG -001

WPIC SLURRY WALL PROFILE

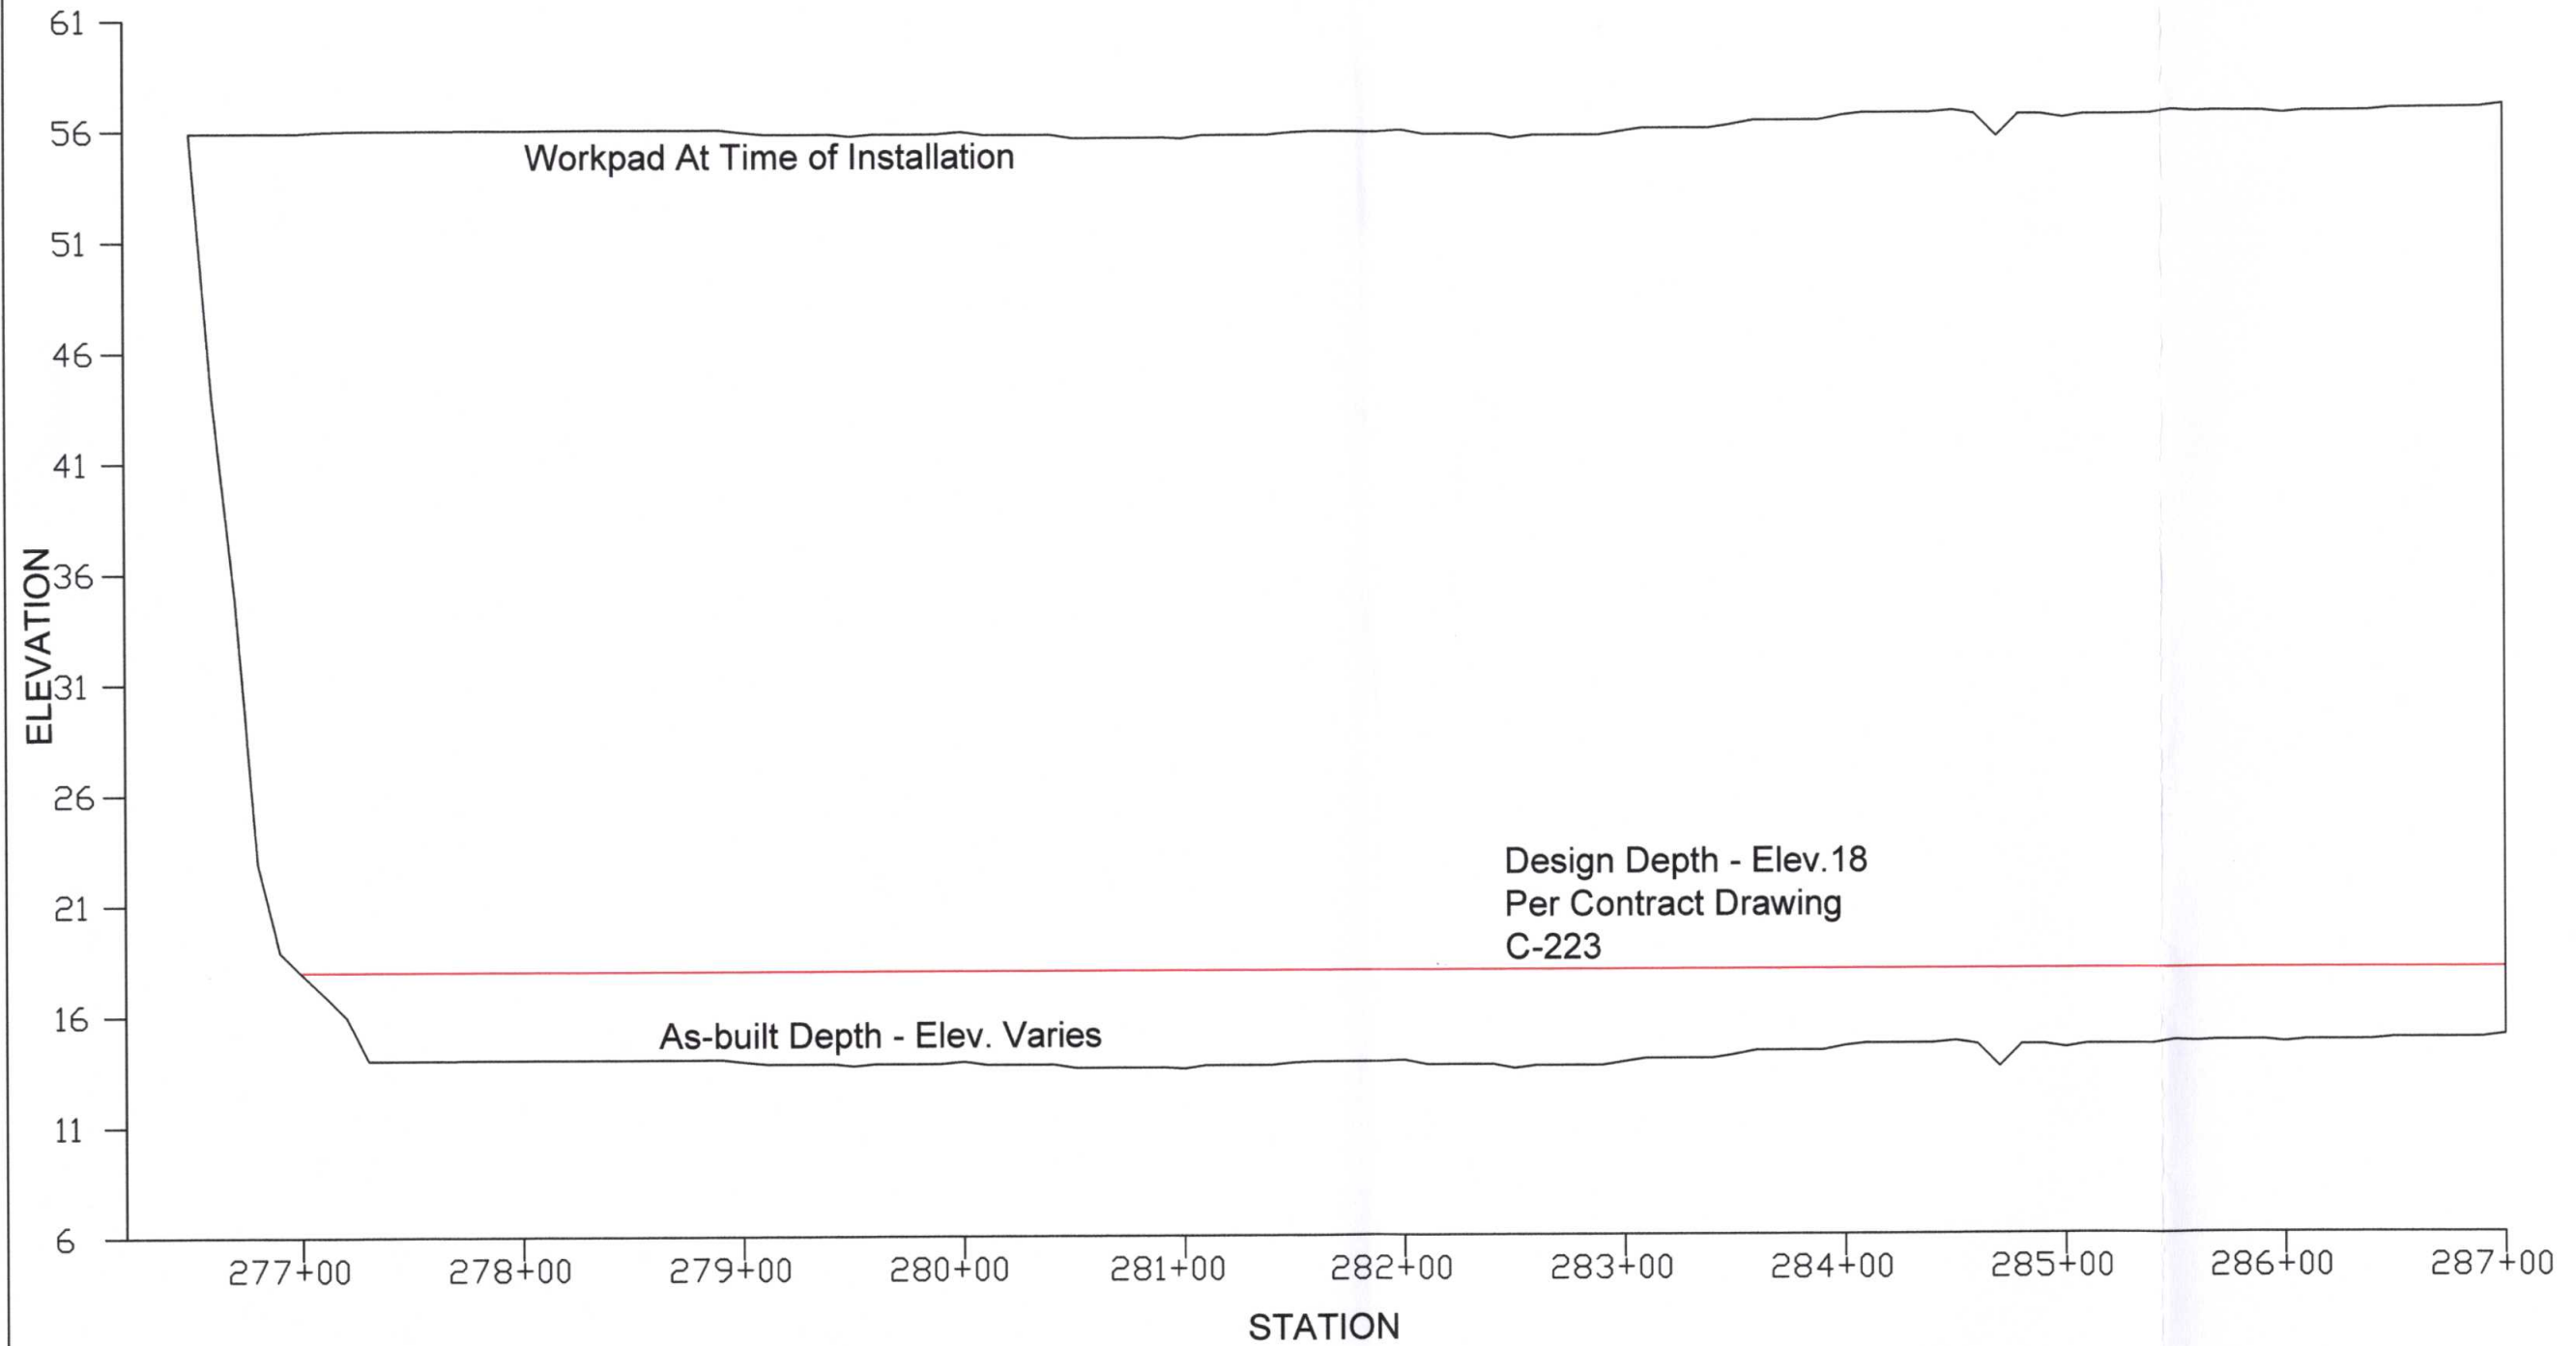

SLURRY WALL PROFILE, BEAR
RIVER WPIC 277+00 - 287+00



11 Oct 05
SLR
Contract No.
Ph 2-2005/06-01

FIG -002